

TINTIC INDUSTRIAL LEAD REALIGNMENT
MILEPOST 746.29, SHARP SUBDIVISION
FEBRUARY 23, 2017



DRAWING INDEX

- 01 COVER SHEET
- 02 TRACK PLAN
- 03 TRACK PLAN
- 04 TRACK PLAN

SCOPE OF WORK:

UPRR:
INSTALL 393 TF
SHIFT 273 TF
REMOVE 180 TF
INSTALL 1 - No. 15 LH POTO
INSTALL 1 - TYPE 2 RH POWER DSPD

INDUSTRY:
FURNISH 357 TF
FURNISH 1 - No. 15 LH POTO
FURNISH 1 - TYPE 2 RH POWER DSPD
FURNISH & INSTALL 7,022 TF
SHIFT 139 TF
REMOVE 927 TF
FURNISH & INSTALL 1 - No. 9 RH HTTO
FURNISH & INSTALL 1 - No. 11 LH HTTO
FURNISH & INSTALL 1 - TYPE 2 SLIDING
DERAIL w/ WHEEL CROWDER
REMOVE 1 - No. 11 LH HTTO

VARIANCES:

1. TRACK A IS IN A CURVE THROUGH THE PROP. BRIDGE.
2. 23' T.C. FOR TRACK A FROM MAINLINE PER UTA AGREEMENT.

Jim Hall
801 428-9224


Tuesday
3/21/17
8:30 am.
meeting

- MOU UPRR MAG UTA UIDOT Spanish Fork Springville

- UPRR Conceptual is approved

Stacy Marshall (801) 668-2155

PRELIMINARY
NOT FOR CONSTRUCTION

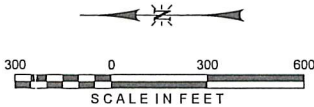


RAILPROS
FIELD SERVICES

360 S. FORT LN, STE. # 3A - LAYTON, UTAH 84041
www.railprosfs.com

DRAWN BY:
RH
CHECKED BY:
SM
DATE:
2/23/2017
SHEET NUMBER
1 of 4

FOR USE IN AGREEMENT WITH: **UNION PACIFIC RAILROAD**
LOCATION & DESCRIPTION:
TINTIC INDUSTRIAL LEAD REALIGNMENT
MP 747.04, SHARP SUBDIVISION, SPANISH FORK, UT
SHEET TITLE:
COVER SHEET

Color table:
c:\UPRR\CAD\workspace\Standards\Tables\Pen\UPRR_VB1_Pentable.tbl
R:\Engineering\6F50003 - MRC - Tintic Ind Lead Realignment\CAD\CAD Exhibits\03 Tintic 10% Design.dgn
3/6/2017

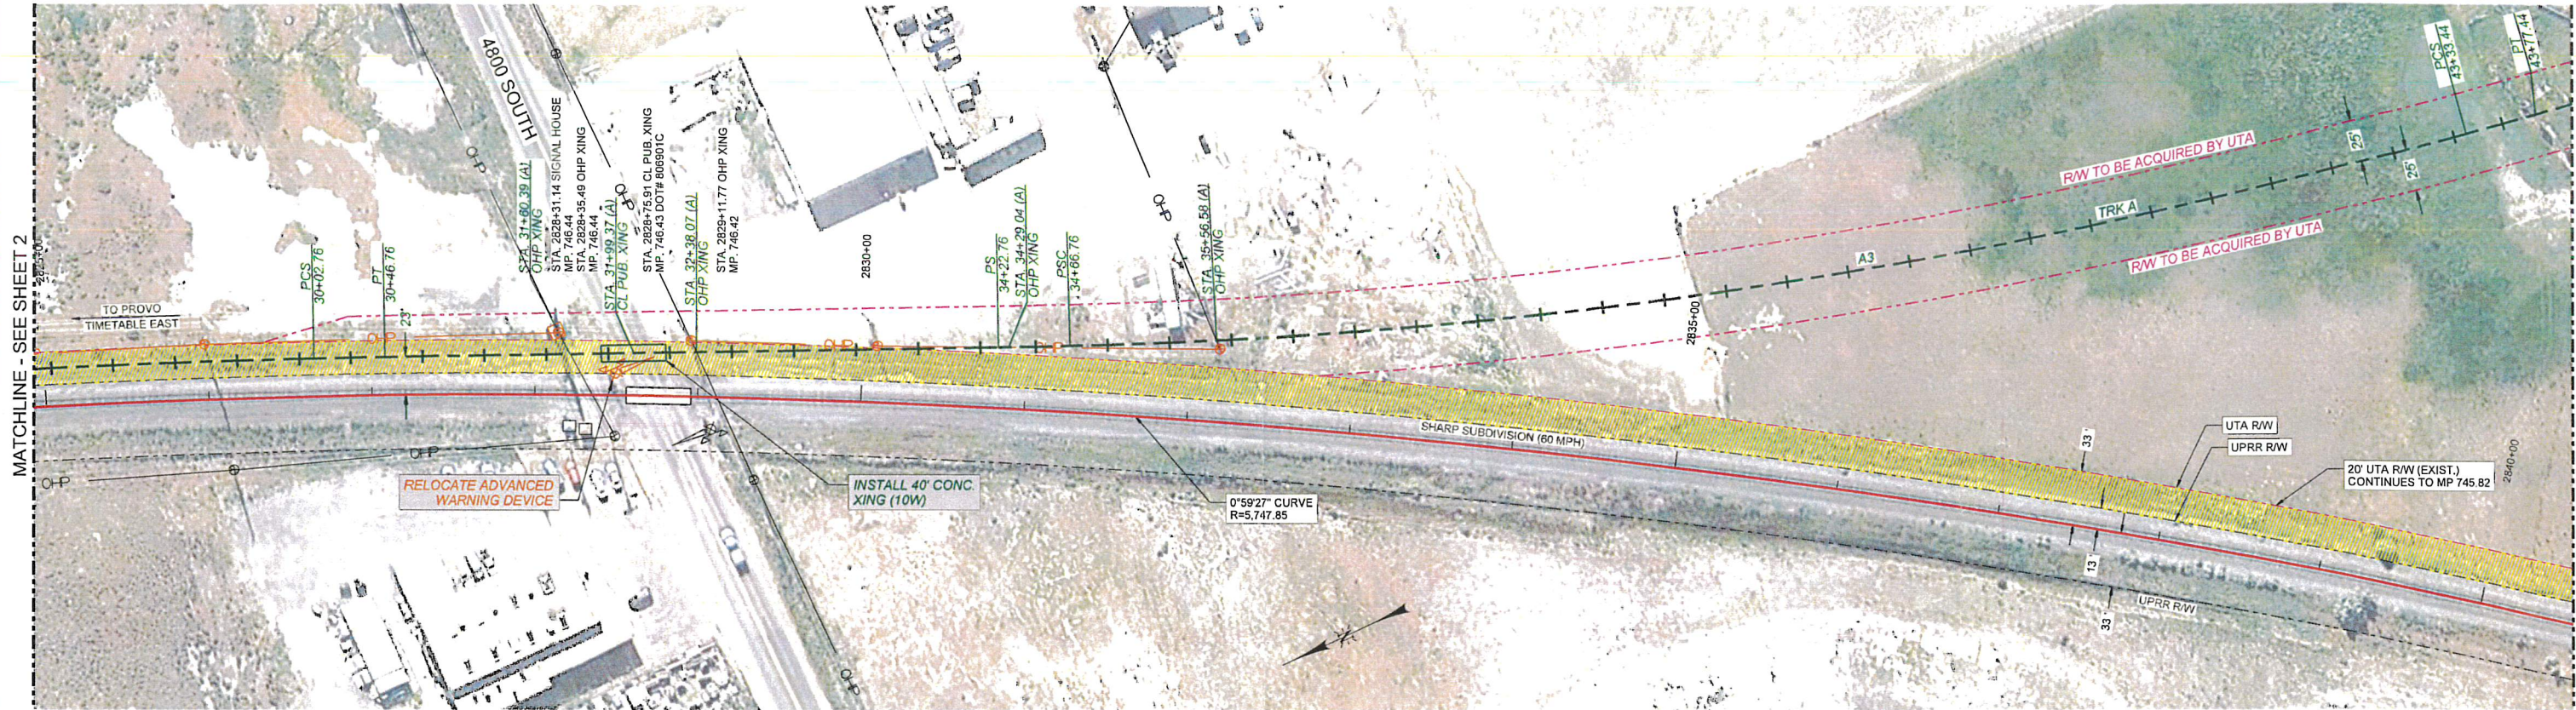

CURVE A3
D = 1°38'01"
R = 3507.49'
DELTA = 14°52'36"
L = 866.68'
S/L = 44.00'
1" = 20 MPH

CURVE A4
D = 1°38'01"
R = 3507.49'
DELTA = 27°06'01"
L = 1614.96'
S/L = 44.00'
1" = 20 MPH



CONCEPT DESIGN

PRELIMINARY
NOT FOR CONSTRUCTION


RAILPROS
FIELD SERVICES

360 S. FORT LN, STE. # 3A - LAYTON, UTAH 84041
www.railprosfs.com

DRAWN BY:
RH
CHECKED BY:
SM
DATE:
2/23/2017
SHEET NUMBER
3 of 4

FOR USE IN AGREEMENT WITH: **UNION PACIFIC RAILROAD**
LOCATION & DESCRIPTION:
TINTIC INDUSTRIAL LEAD REALIGNMENT
MP 747.04, SHARP SUBDIVISION, SPANISH FORK, UT
SHEET TITLE:
TRACK PLAN

Color table:
C:\UPRR\CAD\Workspaces\Standards\Tables\PenUPRR_V81_Pentable.tbl
R:\Engineering\16750003 - MRC - Tintic Ind Lead Realignment\CAD\CAD Exhibits\04 Tintic 10% Design.dgn
3/6/2017

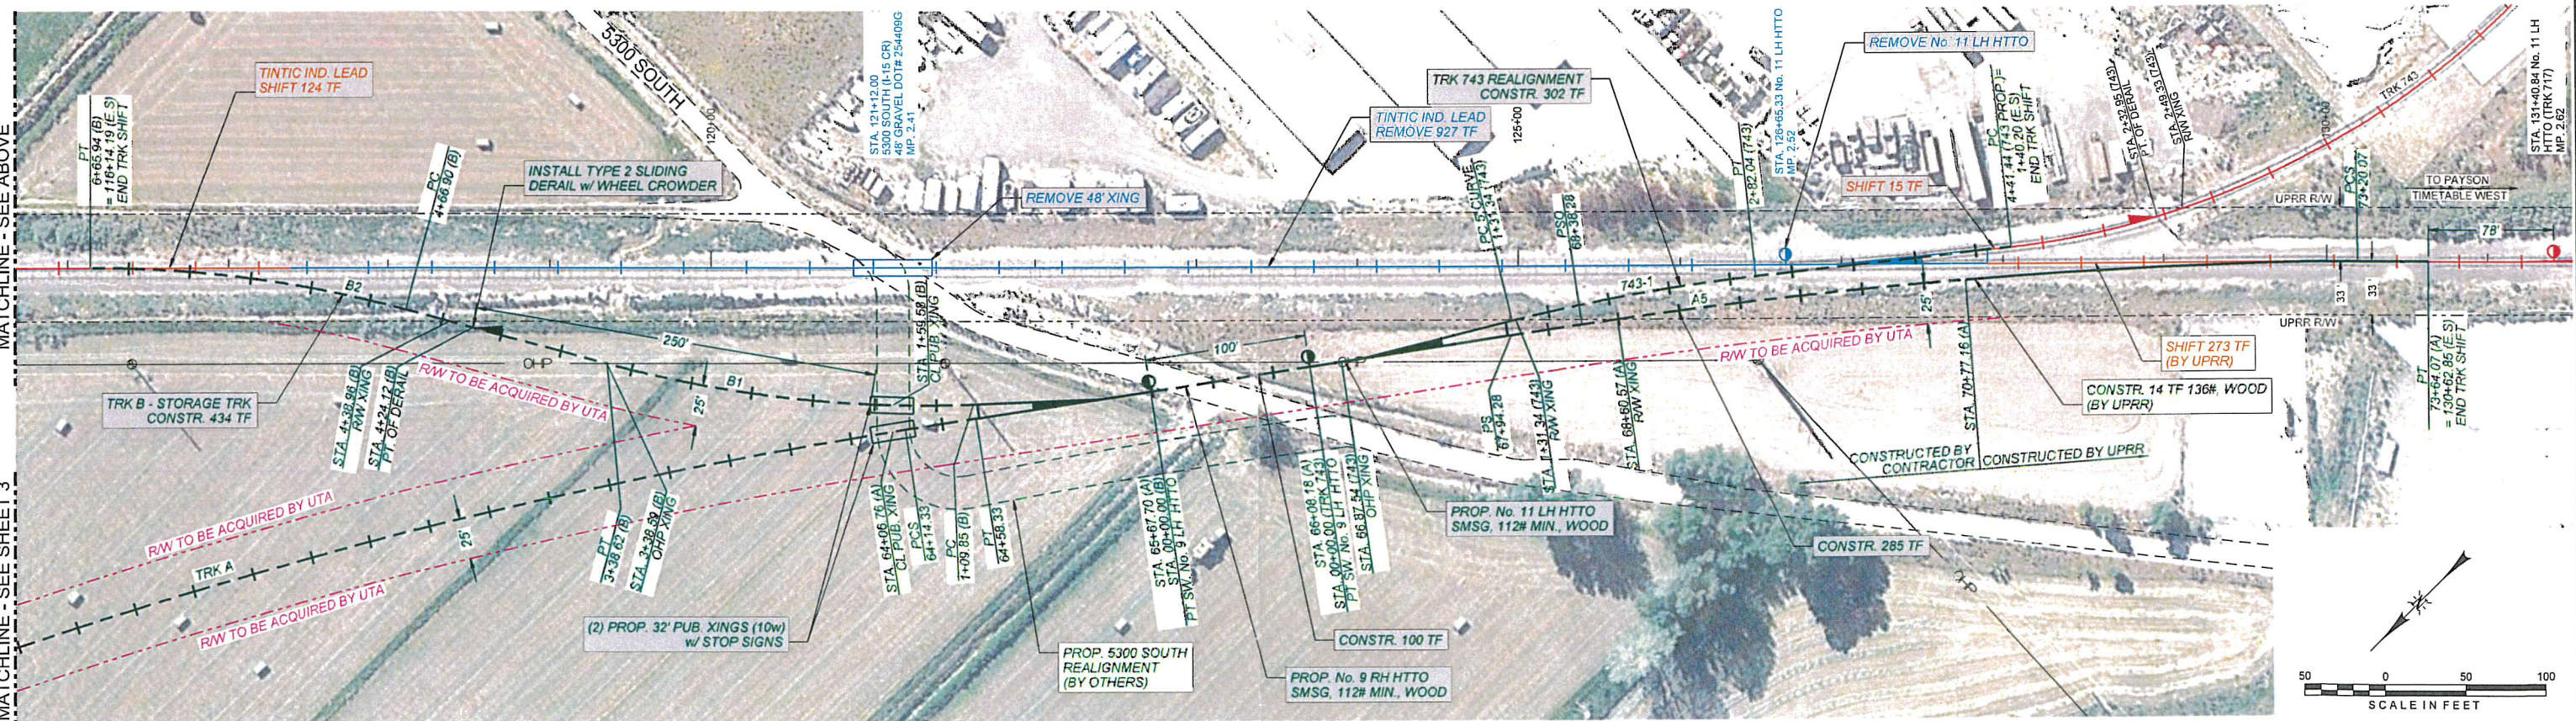

PRELIMINARY
NOT FOR CONSTRUCTION

CURVE A5
D = 1°38'01"
R = 3507.49'
DELTA = 8°35'21"
L = 481.79'
S/L = 44.00'
1° - 20 MPH

CURVE B1
D = 7°30'00"
R = 764.49'
DELTA = 17°09'27"
L = 228.77'
10 MPH

CURVE B2
D = 7°30'00"
R = 764.49'
DELTA = 14°55'40"
L = 199.04'
10 MPH

CURVE 743 - 1
D = 5°00'00"
R = 1146.28'
DELTA = 7°39'26"
L = 153.14'
10 MPH

RAILPROS
FIELD SERVICES

360 S. FORT LN, STE. # 3A - LAYTON, UTAH 84041
www.railpros.com

DRAWN BY:
RH
CHECKED BY:
SM
DATE:
2/23/2017
SHEET NUMBER:
4 of 4

FOR USE IN AGREEMENT WITH: **UNION PACIFIC RAILROAD**
LOCATION & DESCRIPTION:
TINTIC INDUSTRIAL LEAD REALIGNMENT
MP 747.04, SHARP SUBDIVISION, SPANISH FORK, UT
SHEET TITLE:
TRACK PLAN

MATCHLINE - SEE BELOW

MATCHLINE - SEE ABOVE

MATCHLINE - SEE SHEET 3

**PROJECT NAME: Sharp Tintic Connection
Cost Estimate**

Prepared By: Matt Carter/Jimmy Vegh

Date 6/5/2020

Proposed Project Scope: Connect Sharp Sub to Tintic Sub to abandon part of Tintic sub through Springville.

Approximate Route Reference Mile Post (BEGIN) =	(END) =
Project Length = 0.000 miles	ft
Current FY Year (July-June) = 2020	
Assumed Construction FY Year = 2021	
Construction Items Inflation Factor = 1.10	1 yrs for inflation
Assumed Yearly Inflation for Engineering Services (PE and CE) (%/yr) = 3.25%	
Assumed Yearly Inflation for Right of Way (%/yr) = 4.0%	
Items not Estimated (% of Construction) = 10.0%	
Preliminary Engineering (% of Construction + Incentives) = 14.0%	Inc UPRR design
Construction Engineering (% of Construction + Incentives) = 7.0%	

Construction Items	Cost	Remarks
Public Information Services	\$0	
Roadway and Drainage	\$5,748,206	
Traffic and Safety	\$50,000	
Structures	\$672,000	
Environmental Mitigation	\$250,000	
ITS	\$0	
Subtotal	\$6,720,206	
Items not Estimated (10%)	\$672,021	Items not estimated - 10%
Construction Subtotal	\$7,392,227	
P.E. Cost	P.E. Subtotal	14%
C.E. Cost	C.E. Subtotal	7%
Right of Way	Right of Way Subtotal	
Utilities	Utilities Subtotal	
Incentives	Incentives Subtotal	\$0

Cost Estimate (ePM screen 505)		2020	2021
P.E.		\$1,035,000	\$1,069,000
Right of Way		\$988,000	\$1,027,000
Utilities		\$100,000	\$110,000
Construction		\$7,392,000	\$8,149,000
C.E.		\$517,000	\$534,000
Incentives		\$0	\$0
Aesthetics	0.00%	\$0	\$0
Change Order Contingency	1.71%	\$126,299	\$139,000
UDOT Oversight	2.00%	\$160,000	\$176,000
TOTAL		\$10,318,299	\$11,204,000

PROPOSED COMMISSION REQUEST	TOTAL \$10,318,299	TOTAL \$11,204,000
------------------------------------	---------------------------	---------------------------

Project Assumptions/Risks

1	_____	_____
2	_____	_____
3	_____	_____
4	_____	_____
5	_____	_____
6	_____	_____
7	_____	_____

Inflation

PROJECT NAME: Sharp Tintic Connection

Year	Rate	Recommended Rate	Cumulative Inflation Factor
2019	6.5%	0.0%	1.00
2020	5.5%	5.5%	1.06
2021	4.5%	4.5%	1.10
2022	4.0%	4.0%	1.15
2023	3.5%	3.5%	1.19
2024	3.5%	3.5%	1.23
2025	3.5%	3.5%	1.27
2026	3.5%	3.5%	1.32
2027	3.5%	3.5%	1.36
2028	3.5%	3.5%	1.41
2029	3.5%	3.5%	1.46
2030	3.5%	3.5%	1.51
2031	3.5%	3.5%	1.56
2032	3.5%	3.5%	1.62
2033	3.5%	3.5%	1.67
2034	3.5%	3.5%	1.73
2035	3.5%	3.5%	1.79
2036	3.5%	3.5%	1.86
2037	3.5%	3.5%	1.92
2038	3.5%	3.5%	1.99
2039	3.5%	3.5%	2.06
2040	3.5%	3.5%	2.13
2041	3.5%	3.5%	2.20
2042	3.5%	3.5%	2.28
2043	3.5%	3.5%	2.36
2044	3.5%	3.5%	2.44
2045	3.5%	3.5%	2.53
2046	3.5%	3.5%	2.62
2047	3.5%	3.5%	2.71
2048	3.5%	3.5%	2.80

Please contact UDOT Estimate Support with any questions (801-965-4708).

Roadway and Drainage

PROJECT NAME: Sharp Tintic Connection

Item #	Item	Quantity	Units	Price	Cost	Remarks
Roadway						
000001000	Remove Fence - ROW/Field	4,700	LF	\$4.00	\$18,800.00	
000001100	Remove Trees - Within ROW	35	EA	\$750.00	\$26,250.00	
000001200	Remove Curb - South of 4800 S	180	LF	\$7.41	\$1,333.80	
000001300	Remove Asphalt - 4800 S	960	SF	\$1.71	\$1,641.60	
000001400	Remove Crossing - 5300 S	48	LF	\$11.24	\$539.52	
000001600	Clear & Grub - Within ROW	6	ACRE	\$26,334.91	\$158,009.46	
000001700	Over Excavate/Repalce 2- Subgrade	11,000	CY	\$24.14	\$265,540.00	
000001800	Import 2' Select Fill - 4800 S - 5300 S	8,600	CY	\$39.58	\$340,388.00	
000002200	ROW Fence	10,150	LF	\$8.00	\$81,200.00	
000002300	Repair Asphalt - 4800 S	670	SF	\$12.46	\$8,348.20	
000002400	Remove Crossing - Canyon Creek	1	LS	\$15,751.87	\$15,751.87	
000002500	Remove Crossing - 1600 S/1200 W	1	LS	\$12,208.03	\$12,208.03	
000002600	Remove Crossing - 950 W	1	LS	\$24,784.48	\$24,784.48	
000002700	Remove Crossing - Farm Access	1	LS	\$4,439.98	\$4,439.98	
000002800	Remove Crossing 800 S/400 W	1	LS	\$8,766.08	\$8,766.08	
000002900	Remove Crossing 700 S/400 W	1	LS	\$25,952.29	\$25,952.29	
Track UPRR						
000000100	Install 393 TF UPRR	393	TF	\$132.18	\$51,946.74	
000000200	Shift 273 TF UPRR	273	TF	\$54.48	\$14,873.04	
000000300	Remove 180 TF UPRR	180	TF	\$13.83	\$2,489.40	
000000400	Install NO 15 LH POTO	1	EA	\$50,937.91	\$50,937.91	
000000500	Install Type 2 RH Power DSPD	1	EA	\$14,653.09	\$14,653.09	
000000550	Relocate Advanced Warning Devise	1	EA	\$20,000.00	\$20,000.00	
000000700	Railroad Protection	1	LS	\$25,000.00	\$25,000.00	
Track						
000003000	Furnish 357 TF	357	TF	\$127.45	\$45,499.65	
000003100	Furnish No 15 LH POTO	1	EA	\$165,617.50	\$165,617.50	
000003200	Furnish Type 2 RH Power DSPD	1	EA	\$32,055.00	\$32,055.00	
000003300	Furnish and Install 7133 TF	7,133	TF	\$290.56	\$2,072,564.48	
000003400	Shift 139 TF	139	TF	\$60.46	\$8,403.94	
000003500	Remove 927 TF	927	TF	\$14.03	\$13,005.81	
000003600	Furnish and Install No 9 RH HTTO	1	EA	\$94,496.82	\$94,496.82	
000003700	Furnish and Install No11 LH HTTO	1	EA	\$112,978.77	\$112,978.77	
000003800	Furnish and Install Type 2 Sliding Derail	1	EA	\$46,708.09	\$46,708.09	
000003900	Remove No 11 LH HTTO	1	EA	\$11,258.55	\$11,258.55	
000004000	Crossing Panels - 10' Wide	128	TF	\$500.00	\$64,000.00	
000004200	Earthen Bumper	1	EA	\$2,558.68	\$2,558.68	
000005000	Indirects (25%)	1	Lump	\$1,173,237.75	\$1,173,237.75	
000005100	Markup (12%)	1	Lump	\$703,942.56	\$703,942.56	
Roadway Subtotal						
					\$5,720,181	
Drainage						
000001500	Remove Drianage Headwall - MP 746.96 Exist Culvert	1	EA	\$499.86	\$499.86	
000002100	Drainage Culverts	330	LF	\$83.41	\$27,525.30	
Drainage Subtotal						
					\$28,025	
PI						
015407010	Public Information Services	1	lump	\$0.00	\$0	

Traffic, Safety & ITS

PROJECT NAME: Sharp Tintic Connection

Item #	Item	Quantity	Units	Price	Cost	Remarks
Traffic						
Signals						
	Signals work	1	Lump	\$50,000.00	\$50,000.00	
Lighting						
Traffic and Safety Subtotal					\$50,000	
ITS						
ITS Subtotal					\$0	

Structures

PROJECT NAME: Sharp Tintic Connection

Item #	Item	Quantity	Units	Price	Cost	Remarks
Bridges						
000001900	Dry Creek Bridge Structure	1	Lump	\$372,000.00	\$372,000.00	
Walls						
000002000	Retaining Wall	1,200	LF	\$250.00	\$300,000.00	
Structures Subtotal					\$672,000	

Environmental and Landscaping

PROJECT NAME: Sharp Tintic Connection

Item #	Item	Quantity	Units	Price	Cost	Remarks
Environmental						
	Wetland Mitigation	1	Lump	\$250,000.00	\$250,000.00	
Environmental Mitigation Subtotal					\$250,000	

Utilities, Right of Way, and Incentives

PROJECT NAME: Sharp Tintic Connection

Item #	Item	Quantity	Units	Price	Cost	Remarks
Utilities						
	Relocate Utilities	1	Lump	\$100,000.00	\$100,000.00	
Utilities Subtotal					\$100,000	
Right-of-way						
	ROW Purchase	219,550	sq ft	\$4.50	\$987,975.00	
Right-of-Way Subtotal					\$987,975	
Incentives						
Incentives Subtotal					\$0	